




Rf#	Qnt	Revision	Date	Intro	Appr by
1		ORIGINAL	18/04/01	MN	
2		DC 3831	11/07/02	BE	
3		DC 3749	18/03/03	BE	
4		DC 5068	11/08/04	BE	
5		DC 5258	14/10/04	BE	
6		DC 5184	11/01/05	MN	

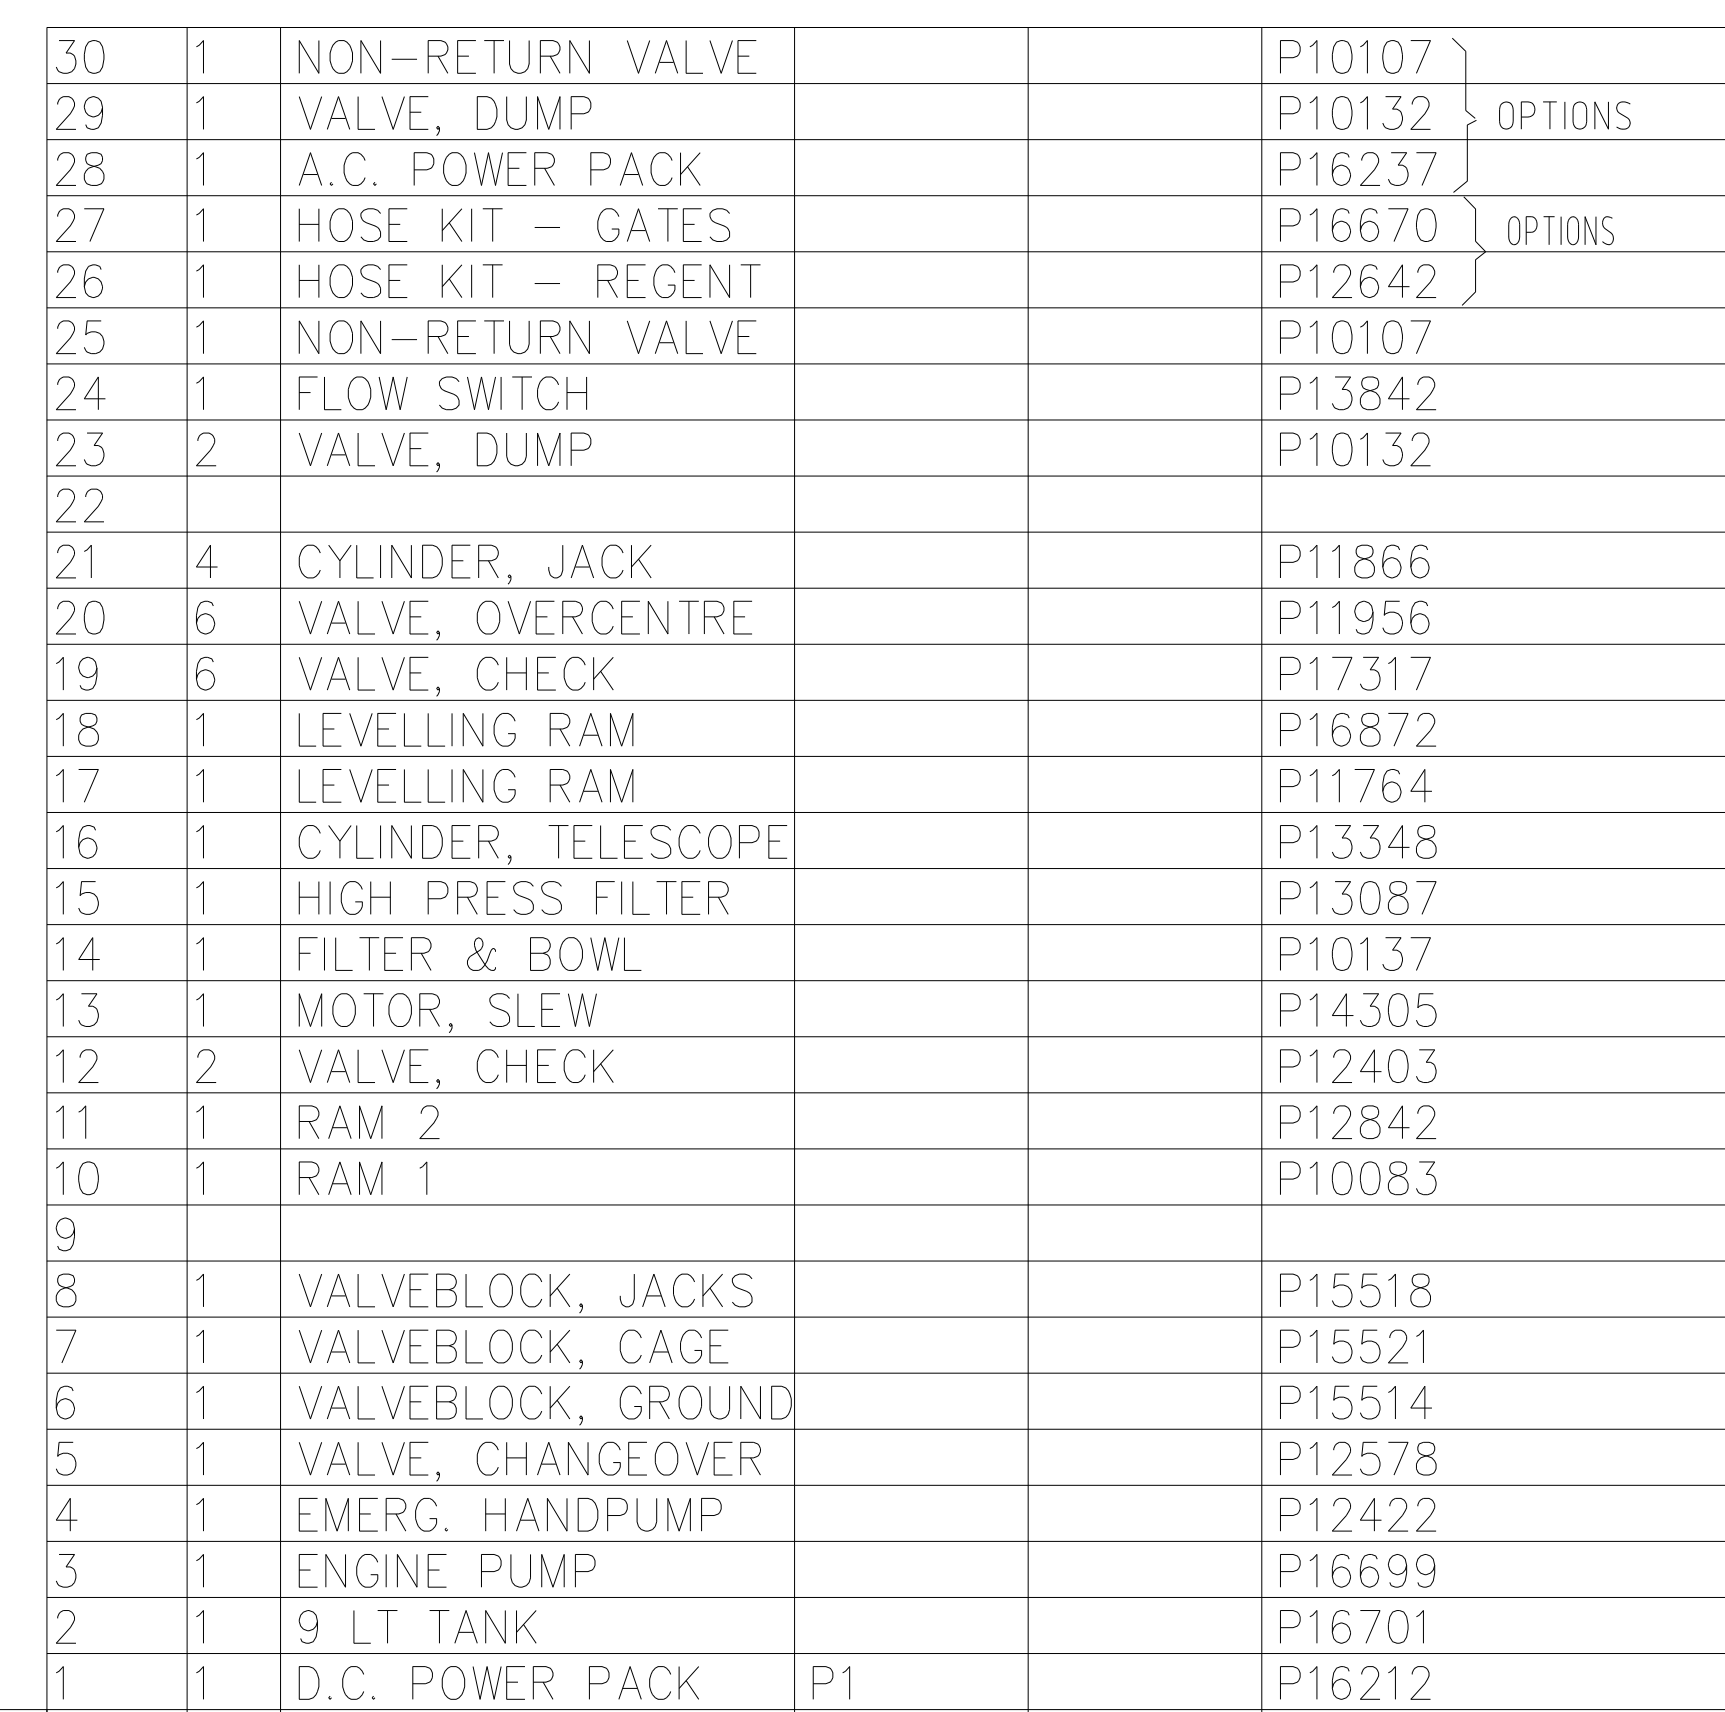

Ref no	Ant	Part name		Material		Dimension		Remark	
Design by MN	Drawn by	Copied	Checked	Standard	Assembled	Scale	1:1	Replace	Replaced by
THIS DRAWING MUST NOT BE COPIED, REPRODUCED OR DISCLOSED TO ANY THIRD PARTY WITHOUT EXPRESS PERMISSION OF NIFTYLUFT LIMITED. ©			120T 'Instinctive'		File D80482 Date 18/04/01				
			HYDRAULIC CIRCUIT		Drawing no D80482				

**nifty**

NIFTYLIFT LIMITED  
Fingle Drive, Stonebridge  
Milton Keynes  
Bucks MK13 0ER  
Telephone: - 01908 223456; Telefax: - 01908 312733